
SAMPLE DOCUMENT: the floor plan is made up to show the format.

APEXON
GLOBAL TECHNOLOGIES

As-Built Drawing: Floor 2 Data Cabling

Site: Example Office, Floor 2, Nairobi (fictional)

Drawing no.: SAMPLE-AB-F2-001 · Not to scale

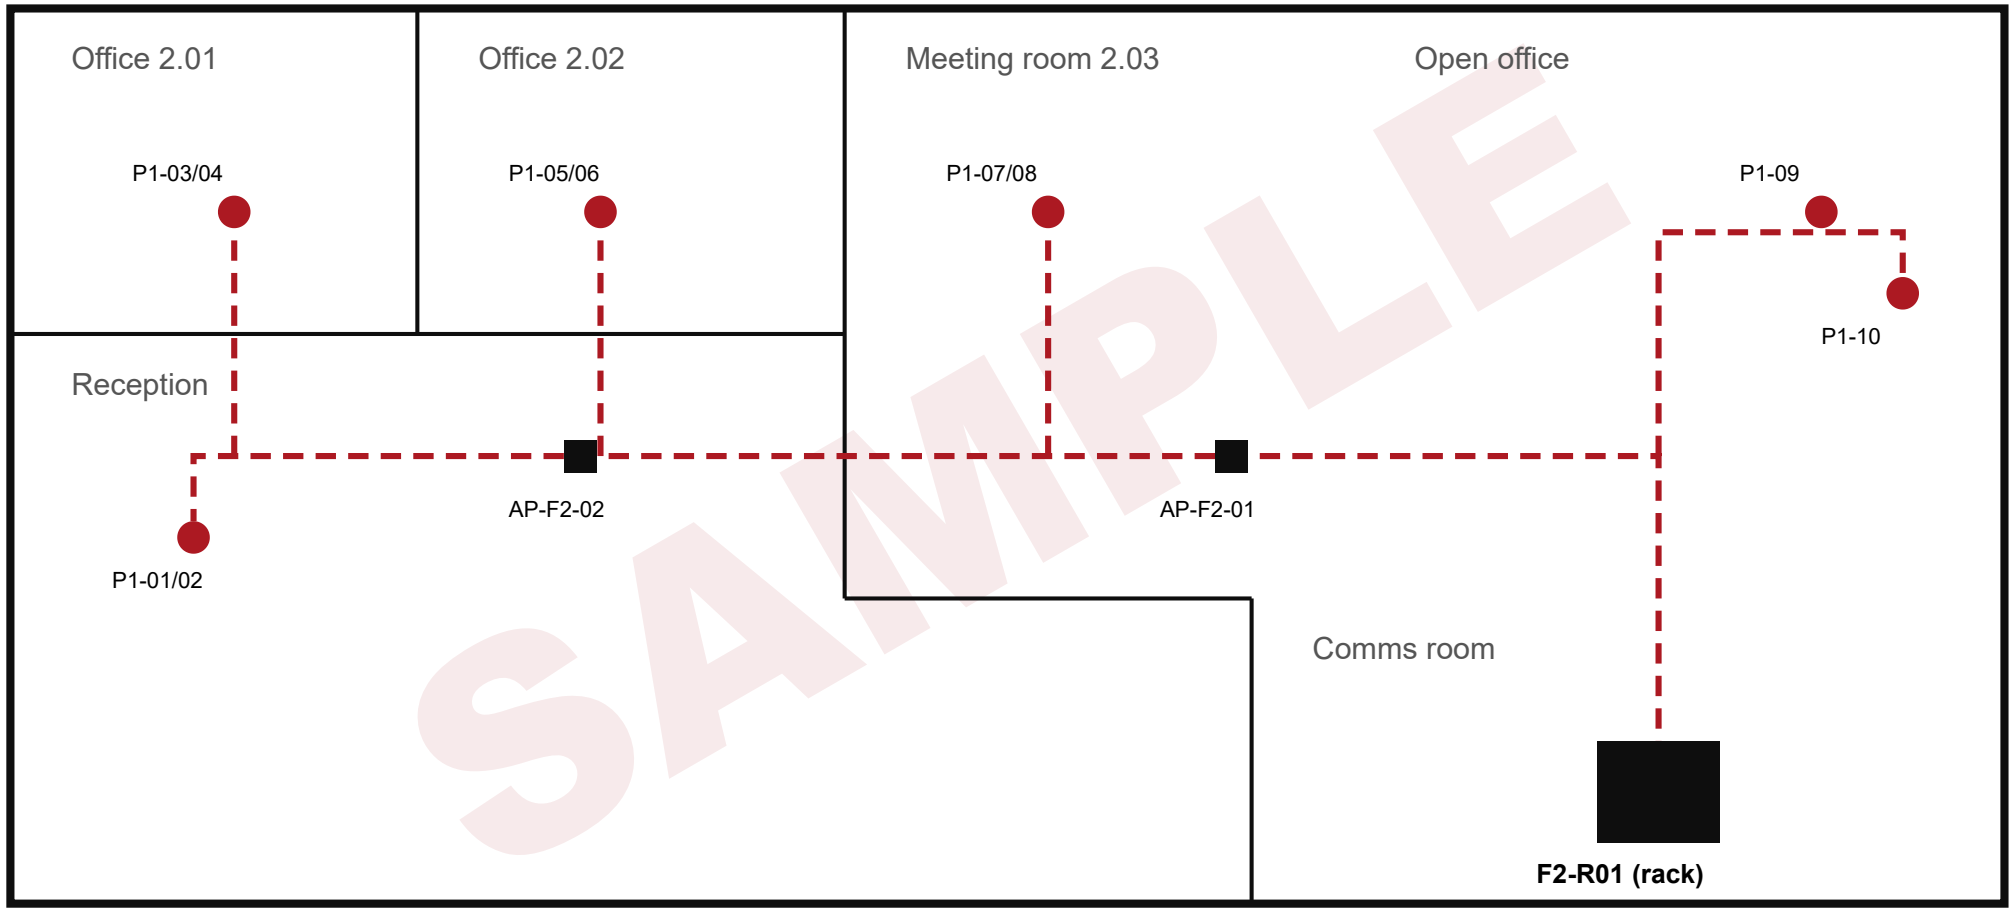

SAMPLE

Symbol	Meaning
● red dot	Data outlet, labelled with its patch-panel ports
■ black square	Ceiling Wi-Fi access point
- - - red dashed line	Cable tray or trunking route as installed

SAMPLE